


SAVARY SHORES IMPROVEMENT DISTRICT Waterworks System Map

BASED ON AS-BUILT DRAWING JUNE 2 1976. REVISED JANUARY 2025.

SAVARY ISLAND

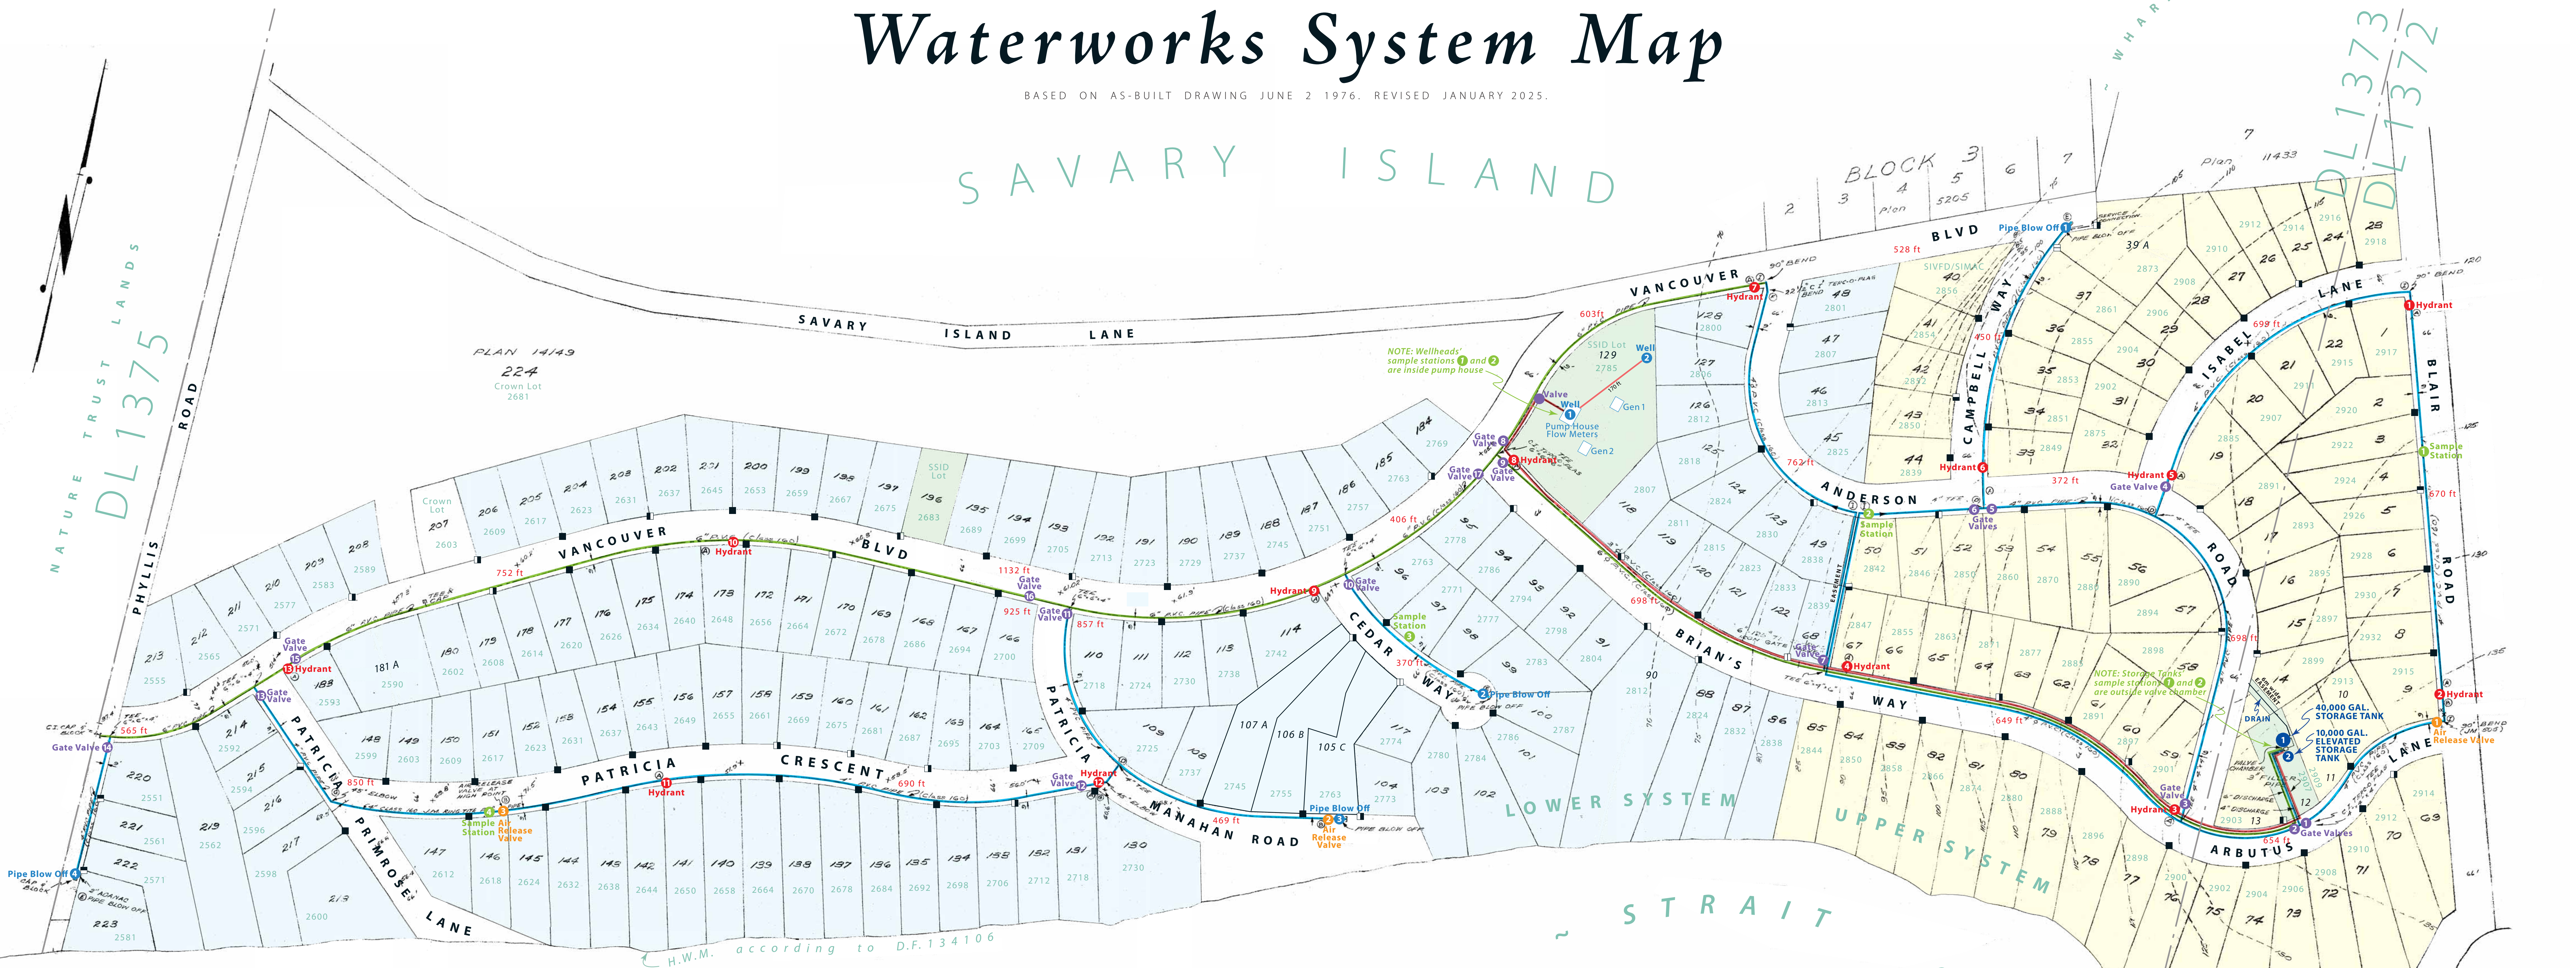

3" SUPPLY LINE	HYDRANTS (13)	SAMPLE STATIONS (8)	UPPER SYSTEM
4" DISTRIBUTION MAIN	PIPE BLOW OFF (4)	AIR RELEASE VALVES (3)	LOWER SYSTEM
6" DISTRIBUTION MAIN	GATE VALVES (17)	STORAGE TANKS (2)	METER BOXES

SCALE: 1 INCH = 100 FEET RIGHT OF WAY ROAD WIDTH: 66 FEET (20.1M)

0 100 200 300 400 500 600 700 800 900 1000 ft

0 100 200 300 m

System map donated by Dale Gregory, SSID Trustee Chair, August 2020.